




Pull, Corner or End Panel Assembly

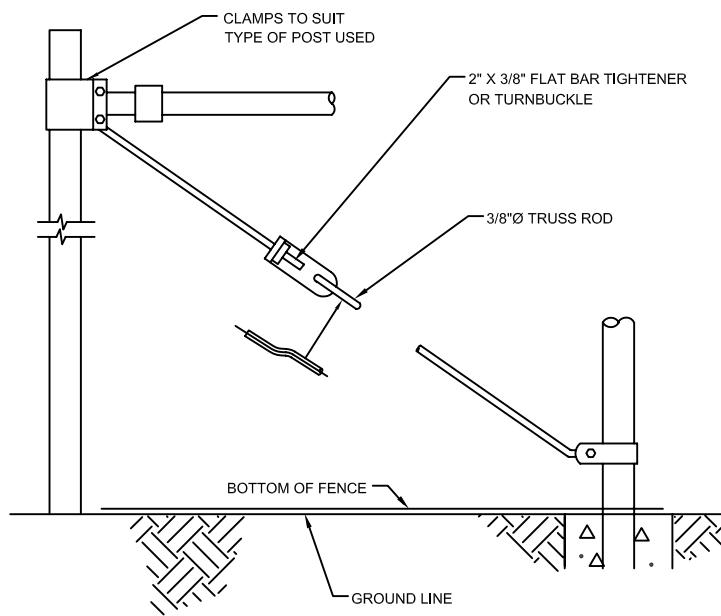

Turnbuckle Detail

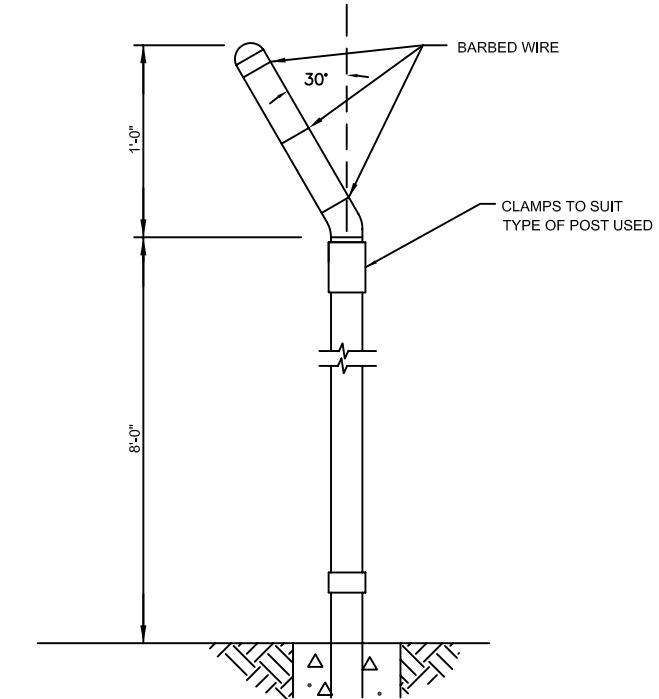


Post Detail

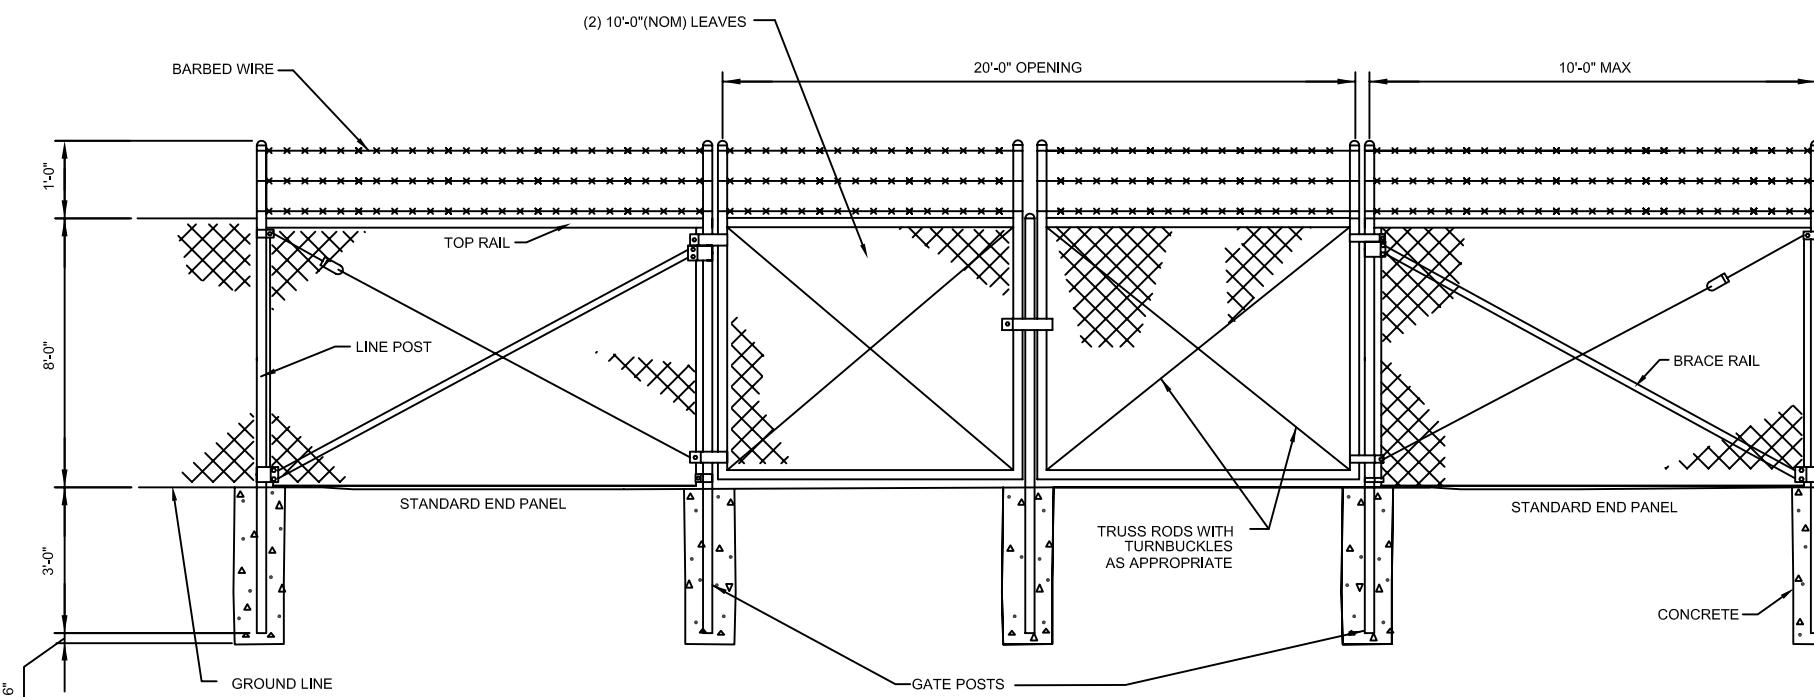


Entrance Gate

Chain Link Fence

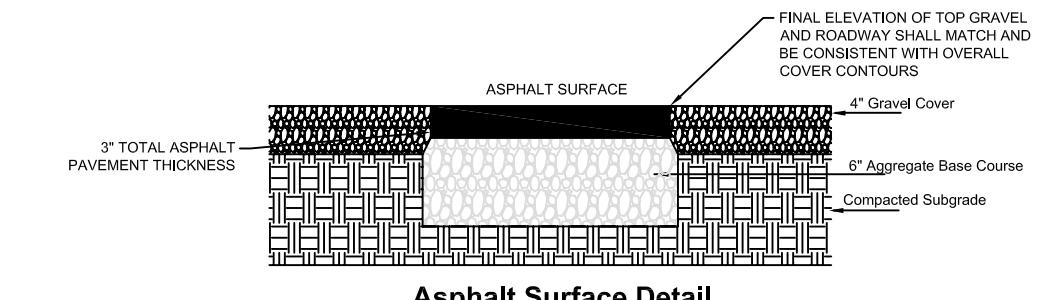

Asphalt Surface Detail

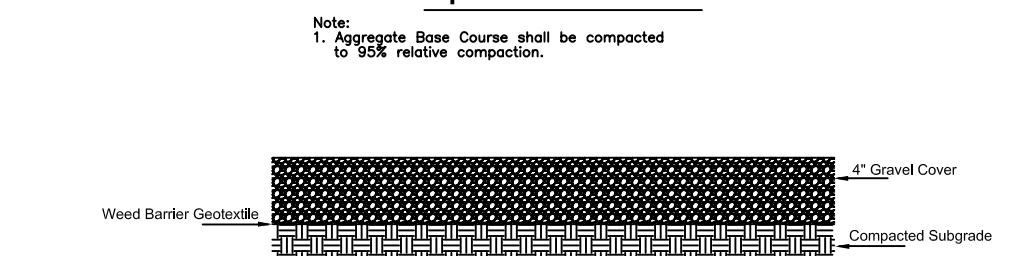

Gravel Surface Detail

FENCE AND SURFACE PAVEMENT DETAILS

PEMACO SUPERFUND SITE
5050 EAST SLAUSON AVENUE
MAYWOOD, CALIFORNIA

PREPARED FOR:
U.S. Environmental Protection Agency
San Francisco, California

PREPARED BY:
TN & Associates, Inc.
& Associates, Inc.
Engineering and Science

SCALE: AS SHOWN	APPROVED
DESIGNED: JW & DC	FINAL
DRAWN: DC	DATE: 03/14/07
CHECKED: JW	DRAWING

REV
C-16
5

AS-BUILT